


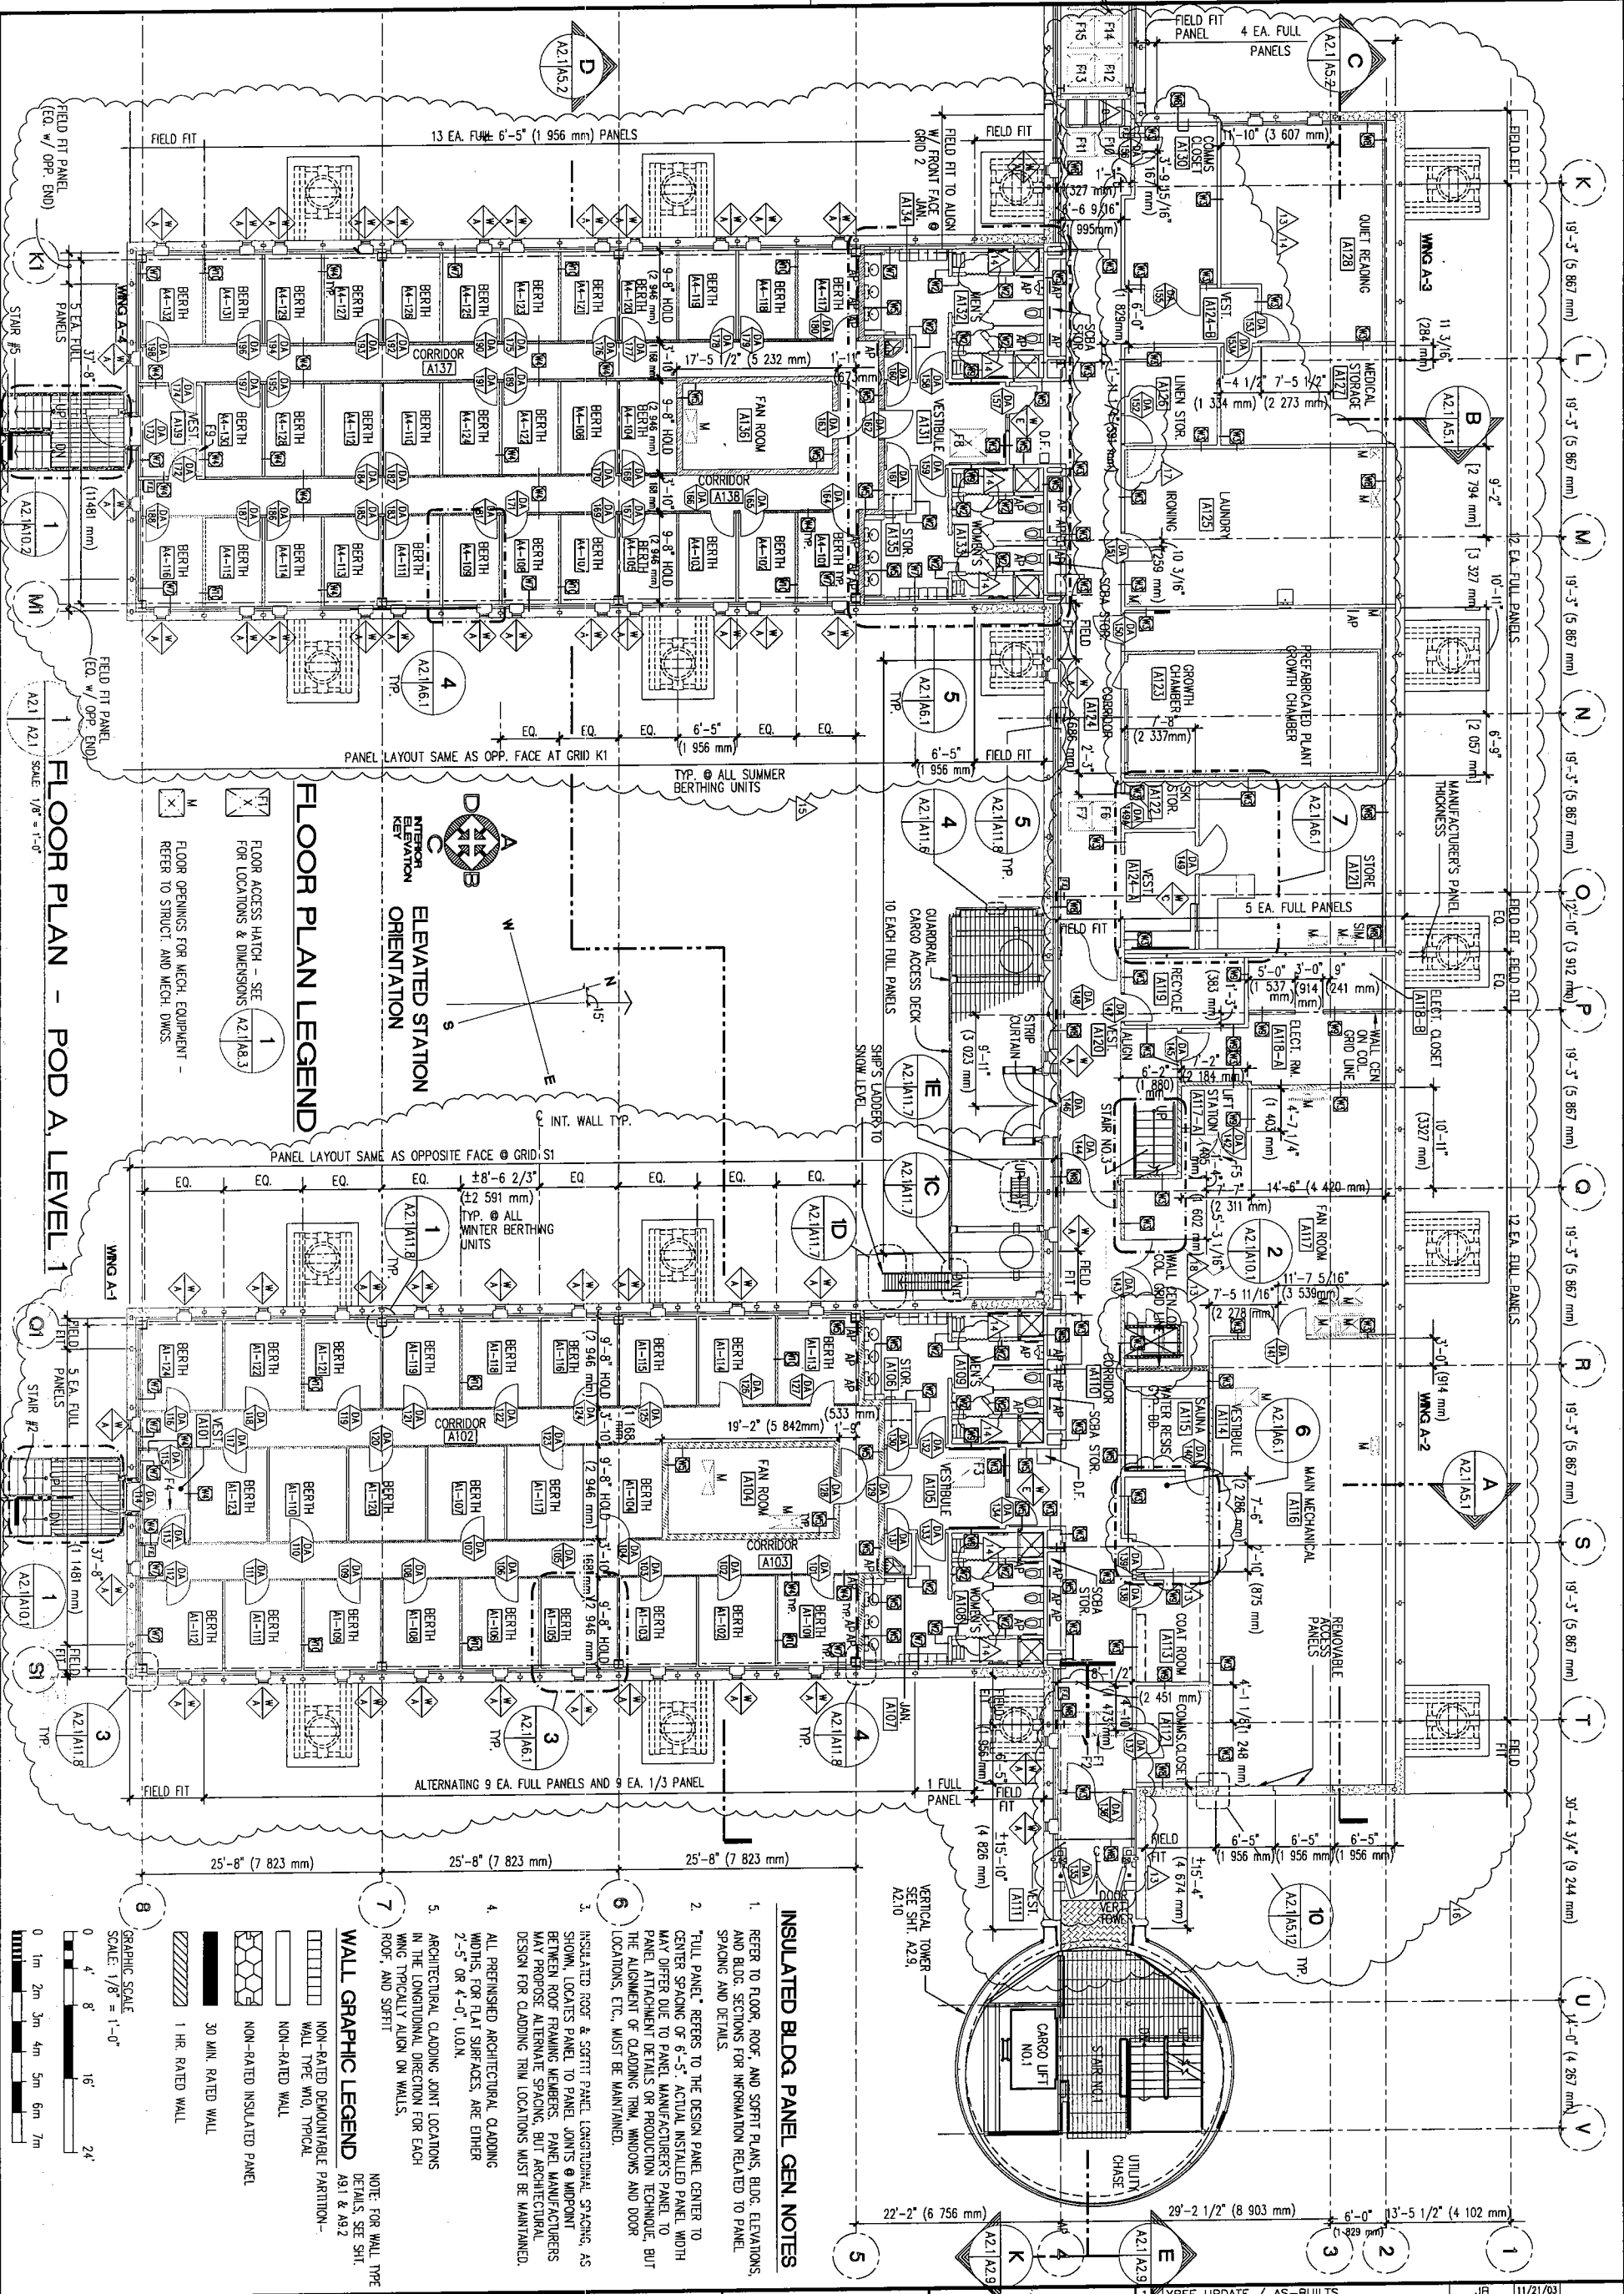

FERRARO CHOI		PACDIV REC: RVD	BR MGR	JB	11/21/03
DES BB	DR BW, EC	CHK GC	OPPE	PDE	INBM
SUPV JF	CH ENG	DATE	DIR	DATE	
SUBMITTED BY:	DATE	APPROVED	DATE		
PARTNER	06/08/98	FOR COMMANDER, NAVFAC			
INSULATED BLDG PANEL GEN. NOTES		XREF UPDATE / AS-BUILTS			
1. REFER TO FLOOR, ROOF, AND SOFFIT PLANS, BLDG. ELEVATIONS, AND BLDG. SECTIONS FOR INFORMATION RELATED TO PANEL SPACING AND DETAILS.		14. REV PER 21 RFI 011, 21 CR 013 & 13 CR 135			
2. "FULL PANEL" REFERS TO THE DESIGN PANEL CENTER TO CENTER SPACING OF 6'-5". ACTUAL INSTALLED PANEL WIDTH MAY DIFFER DUE TO PANEL MANUFACTURER'S PANEL TO PANEL ATTACHMENT DETAILS OR PRODUCTION TECHNIQUE, BUT THE ALIGNMENT OF CLADDING TRIM, WINDOWS AND DOOR LOCATIONS, ETC., MUST BE MAINTAINED.		15. WING A-4 EXPANSION			
3. INSULATED ROOF & SOFFIT PANEL LONGITUDINAL SPACING, AS SHOWN, LOCATES PANEL TO PANEL JOINTS @ MIDPOINT BETWEEN ROOF FRAMING MEMBERS. PANEL MANUFACTURERS MAY PROPOSE ALTERNATE SPACING, BUT ARCHITECTURAL DESIGN FOR CLADDING TRIM LOCATIONS MUST BE MAINTAINED.		16. AS-BUILTS			
4. ALL PREFINISHED ARCHITECTURAL CLADDING WIDTHS, FOR FLAT SURFACES, ARE EITHER 2'-5" OR 4'-0", U.O.N.		17. REV PER 21 RFI 040 & 21 CR 040			
5. ARCHITECTURAL CLADDING JOINT LOCATIONS IN THE LONGITUDINAL DIRECTION FOR EACH WING TYPICALLY ALIGN ON WALLS, ROOF, AND SOFFIT.		18. REV PER 13 RFI 265			
WALL GRAPHIC LEGEND		LTR DESCRIPTION			
NOTE: SEE WALL TYPE DETAILS, SEE SHT. A91 & A92		PREP'D BY DATE APPROVED			
0 1m 2m 3m 4m 5m 6m 7m		REVISIONS			
GRAPHIC SCALE					
SCALE: 1/8" = 1'-0"					
0 4' 8' 16' 24'					
WALL TYPE WNO, TYPICAL					
NON-RATED DEMOUNTABLE PARTITION					
NON-RATED WALL					
NON-RATED INSULATED PANEL					
30 MIN. RATED WALL					
1 HR. RATED WALL					
FLOOR PLAN - POD A, LEVEL 1					
DEPARTMENT OF THE NAVY					
NAVAL FACILITIES ENGINEERING COMMAND					
PACIFIC DIVISION					
MAKALAPA, HAWAII					
SOUTH POLE STATION MODERNIZATION					
ELEVATED STATION					
FLOOR PLAN - POD A, LEVEL 1					
CODE IDENT NO.					
80091					
SIZE D					
CONST. CONTR. NO.					
SPEC. NO. SSPM 20					
NAVFAC DRAWING NO.					
7935231					
SHEET OF					
A2.1					
FINAL SUBMITTAL					