


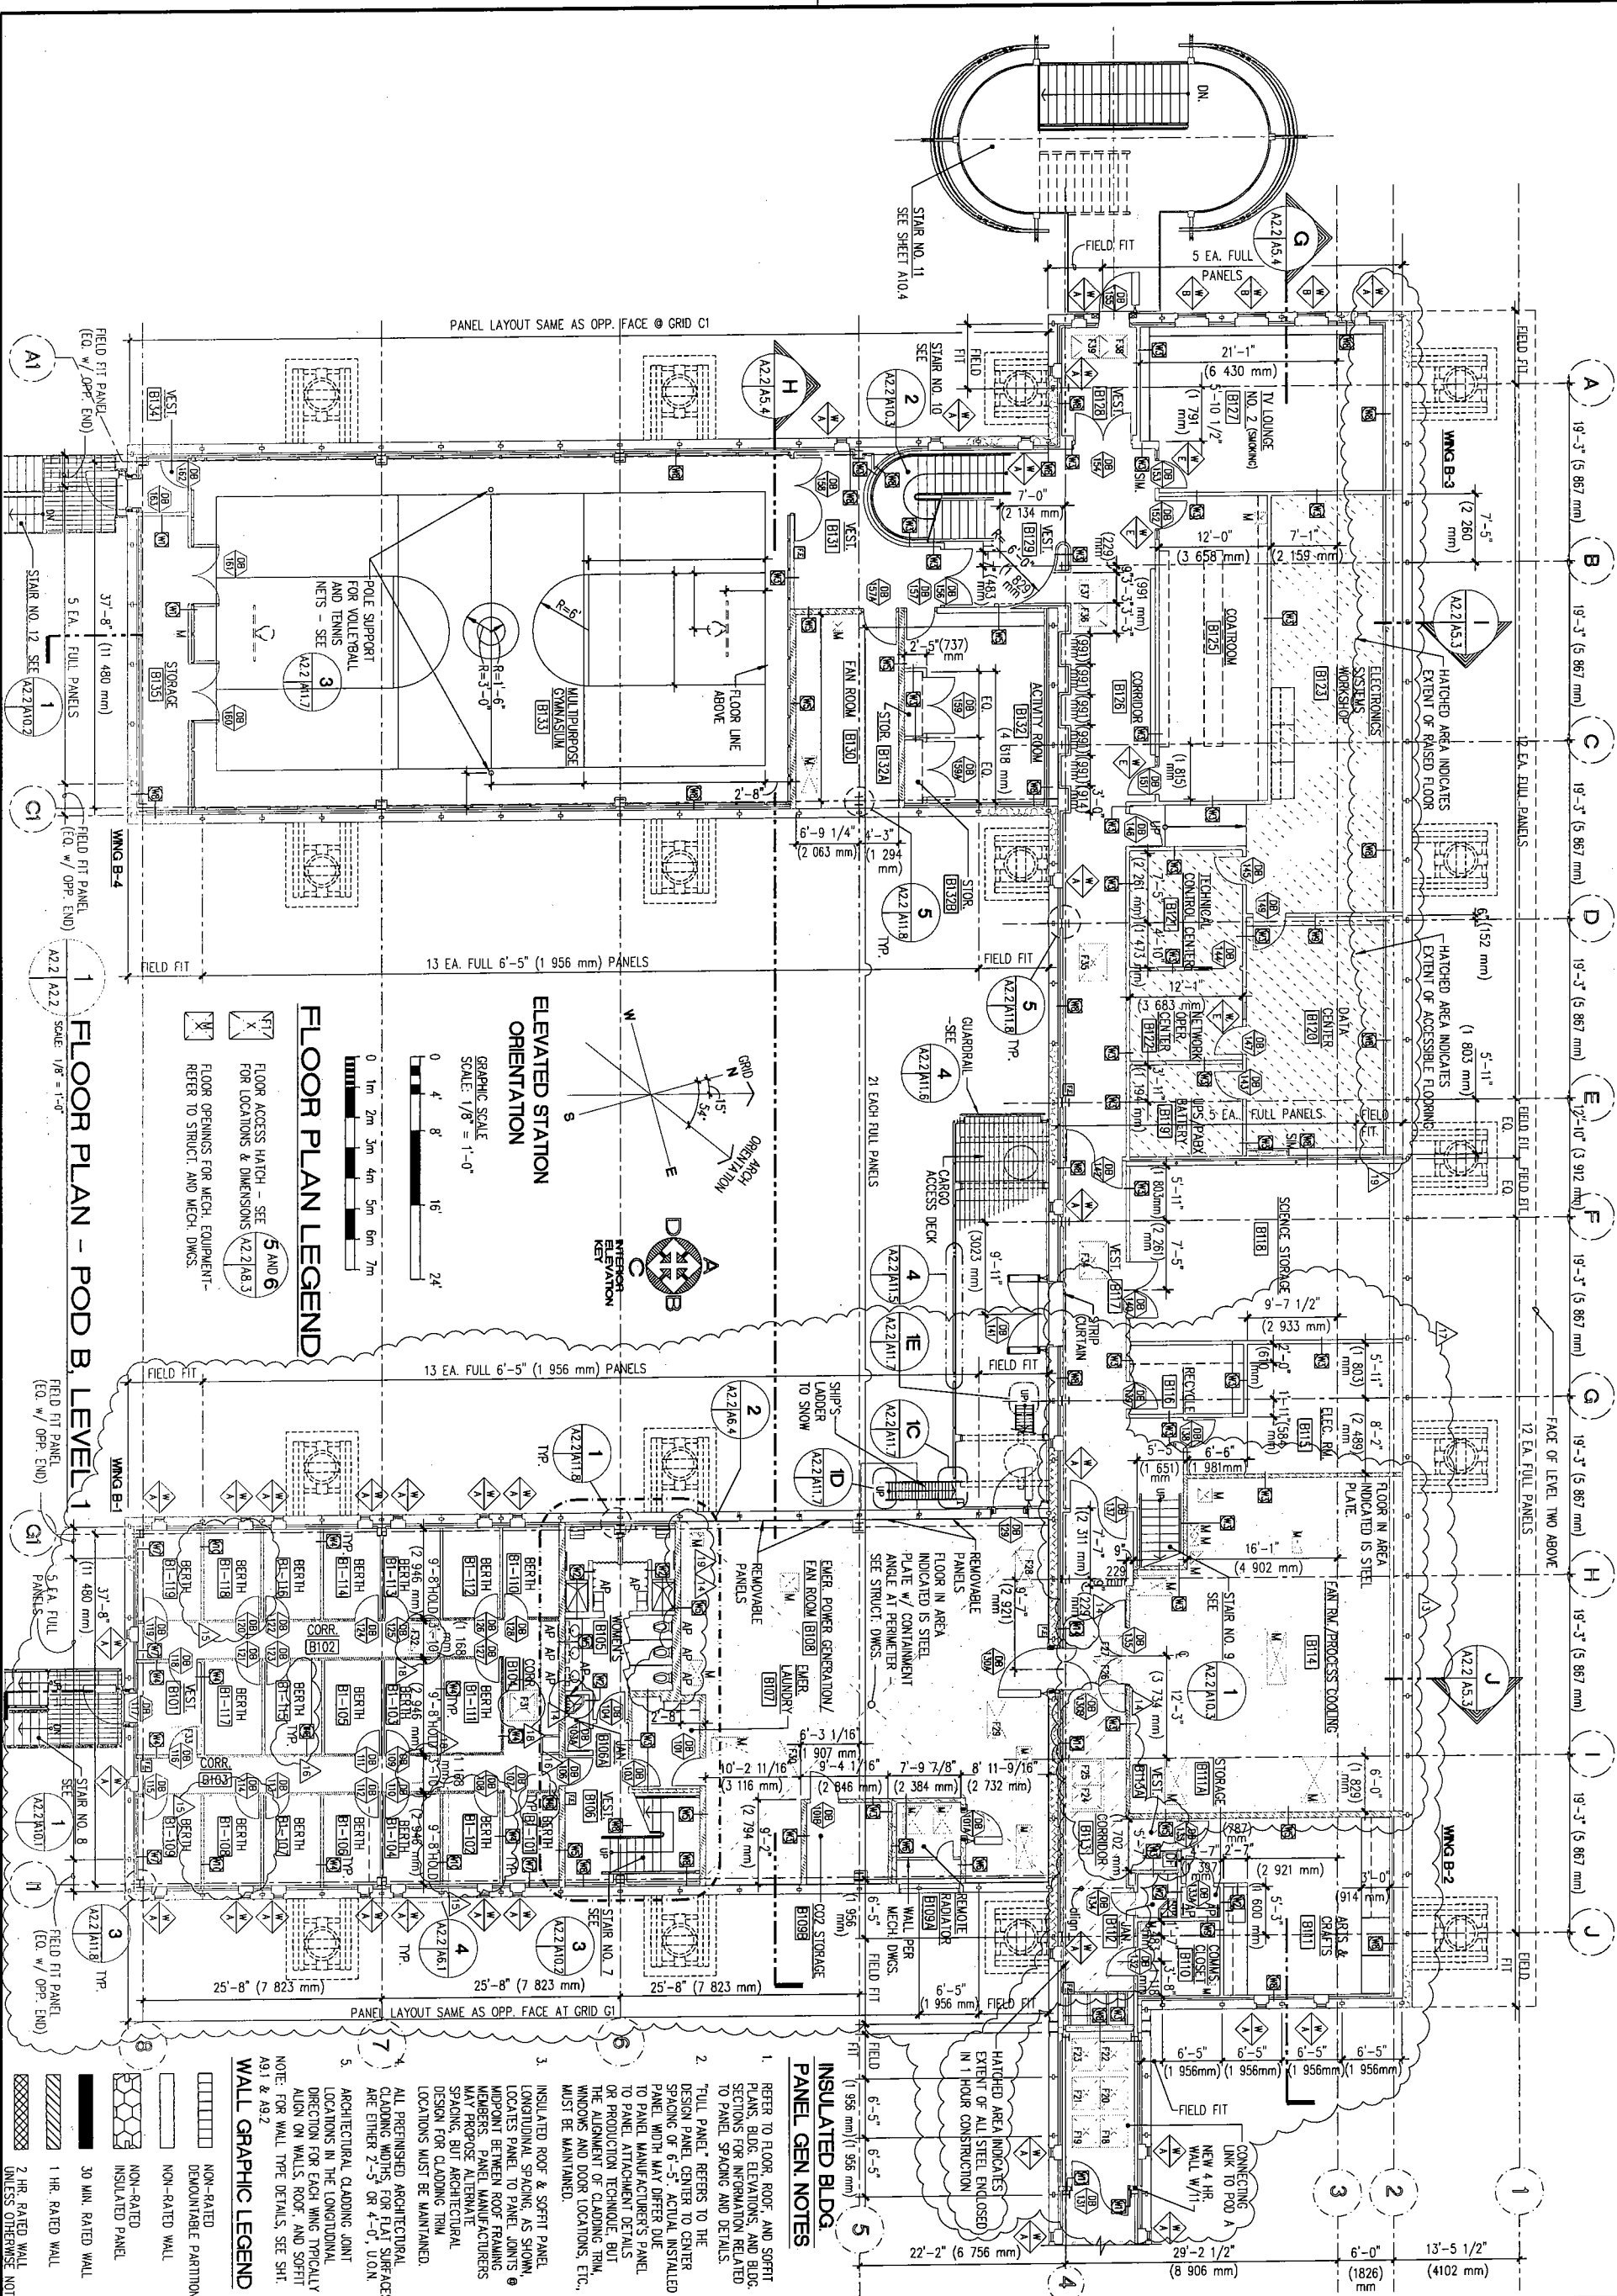

14 REV PER 22 RFI 039 & 24 RFI 025		JB	03/25/04
15 REV PER 24 RFI 034		SR	04/19/04
16 REV PER 24 RFI 045		JB	05/15/04
17 AS-BUILTS		JB	05/20/04
18 REV PER 13 RFI 075		JB	08/10/04
19 REV PER 24 RFI 015 & AS-BUILTS		JB	08/24/04
LTR		PREP'D BY	DATE
DESCRIPTION		DATE	APPROVED
REVISIONS			
FOR COMMANDER, NAVFAC			
PARTNER			
DATE 04/09/99			
APPROVED			
DATE			
DIR			
DFPE			
PACDIV NPEC: RVD			
BR MGR			
DES BB			
DR BW, EC			
CHK GC			
FERRARO CHOI			
SUPERVISOR			
CH ENG			
SUBMITTED BY:			
DATE			
PARTNER			
FLOOR PLAN - POD B, LEVEL 1			
SOUTH POLE STATION MODERNIZATION			
PACIFIC DIVISION			
NAVAL FACILITIES ENGINEERING COMMAND			
DEPARTMENT OF THE NAVY			
CODE IDENT NO.			
80091			
SIZE D			
CONST. CONTR. NO.			
SPEC. NO. SP50 20			
NAVFAC DRAWING NO.			
7935232			
SHEET			
OF			
A2.2			
IF SHEET IS LESS THAN 23" X 34"			
REDUCED PRINT - USE GRAPHIC SCALES			
FINAL SUBMITTAL			