


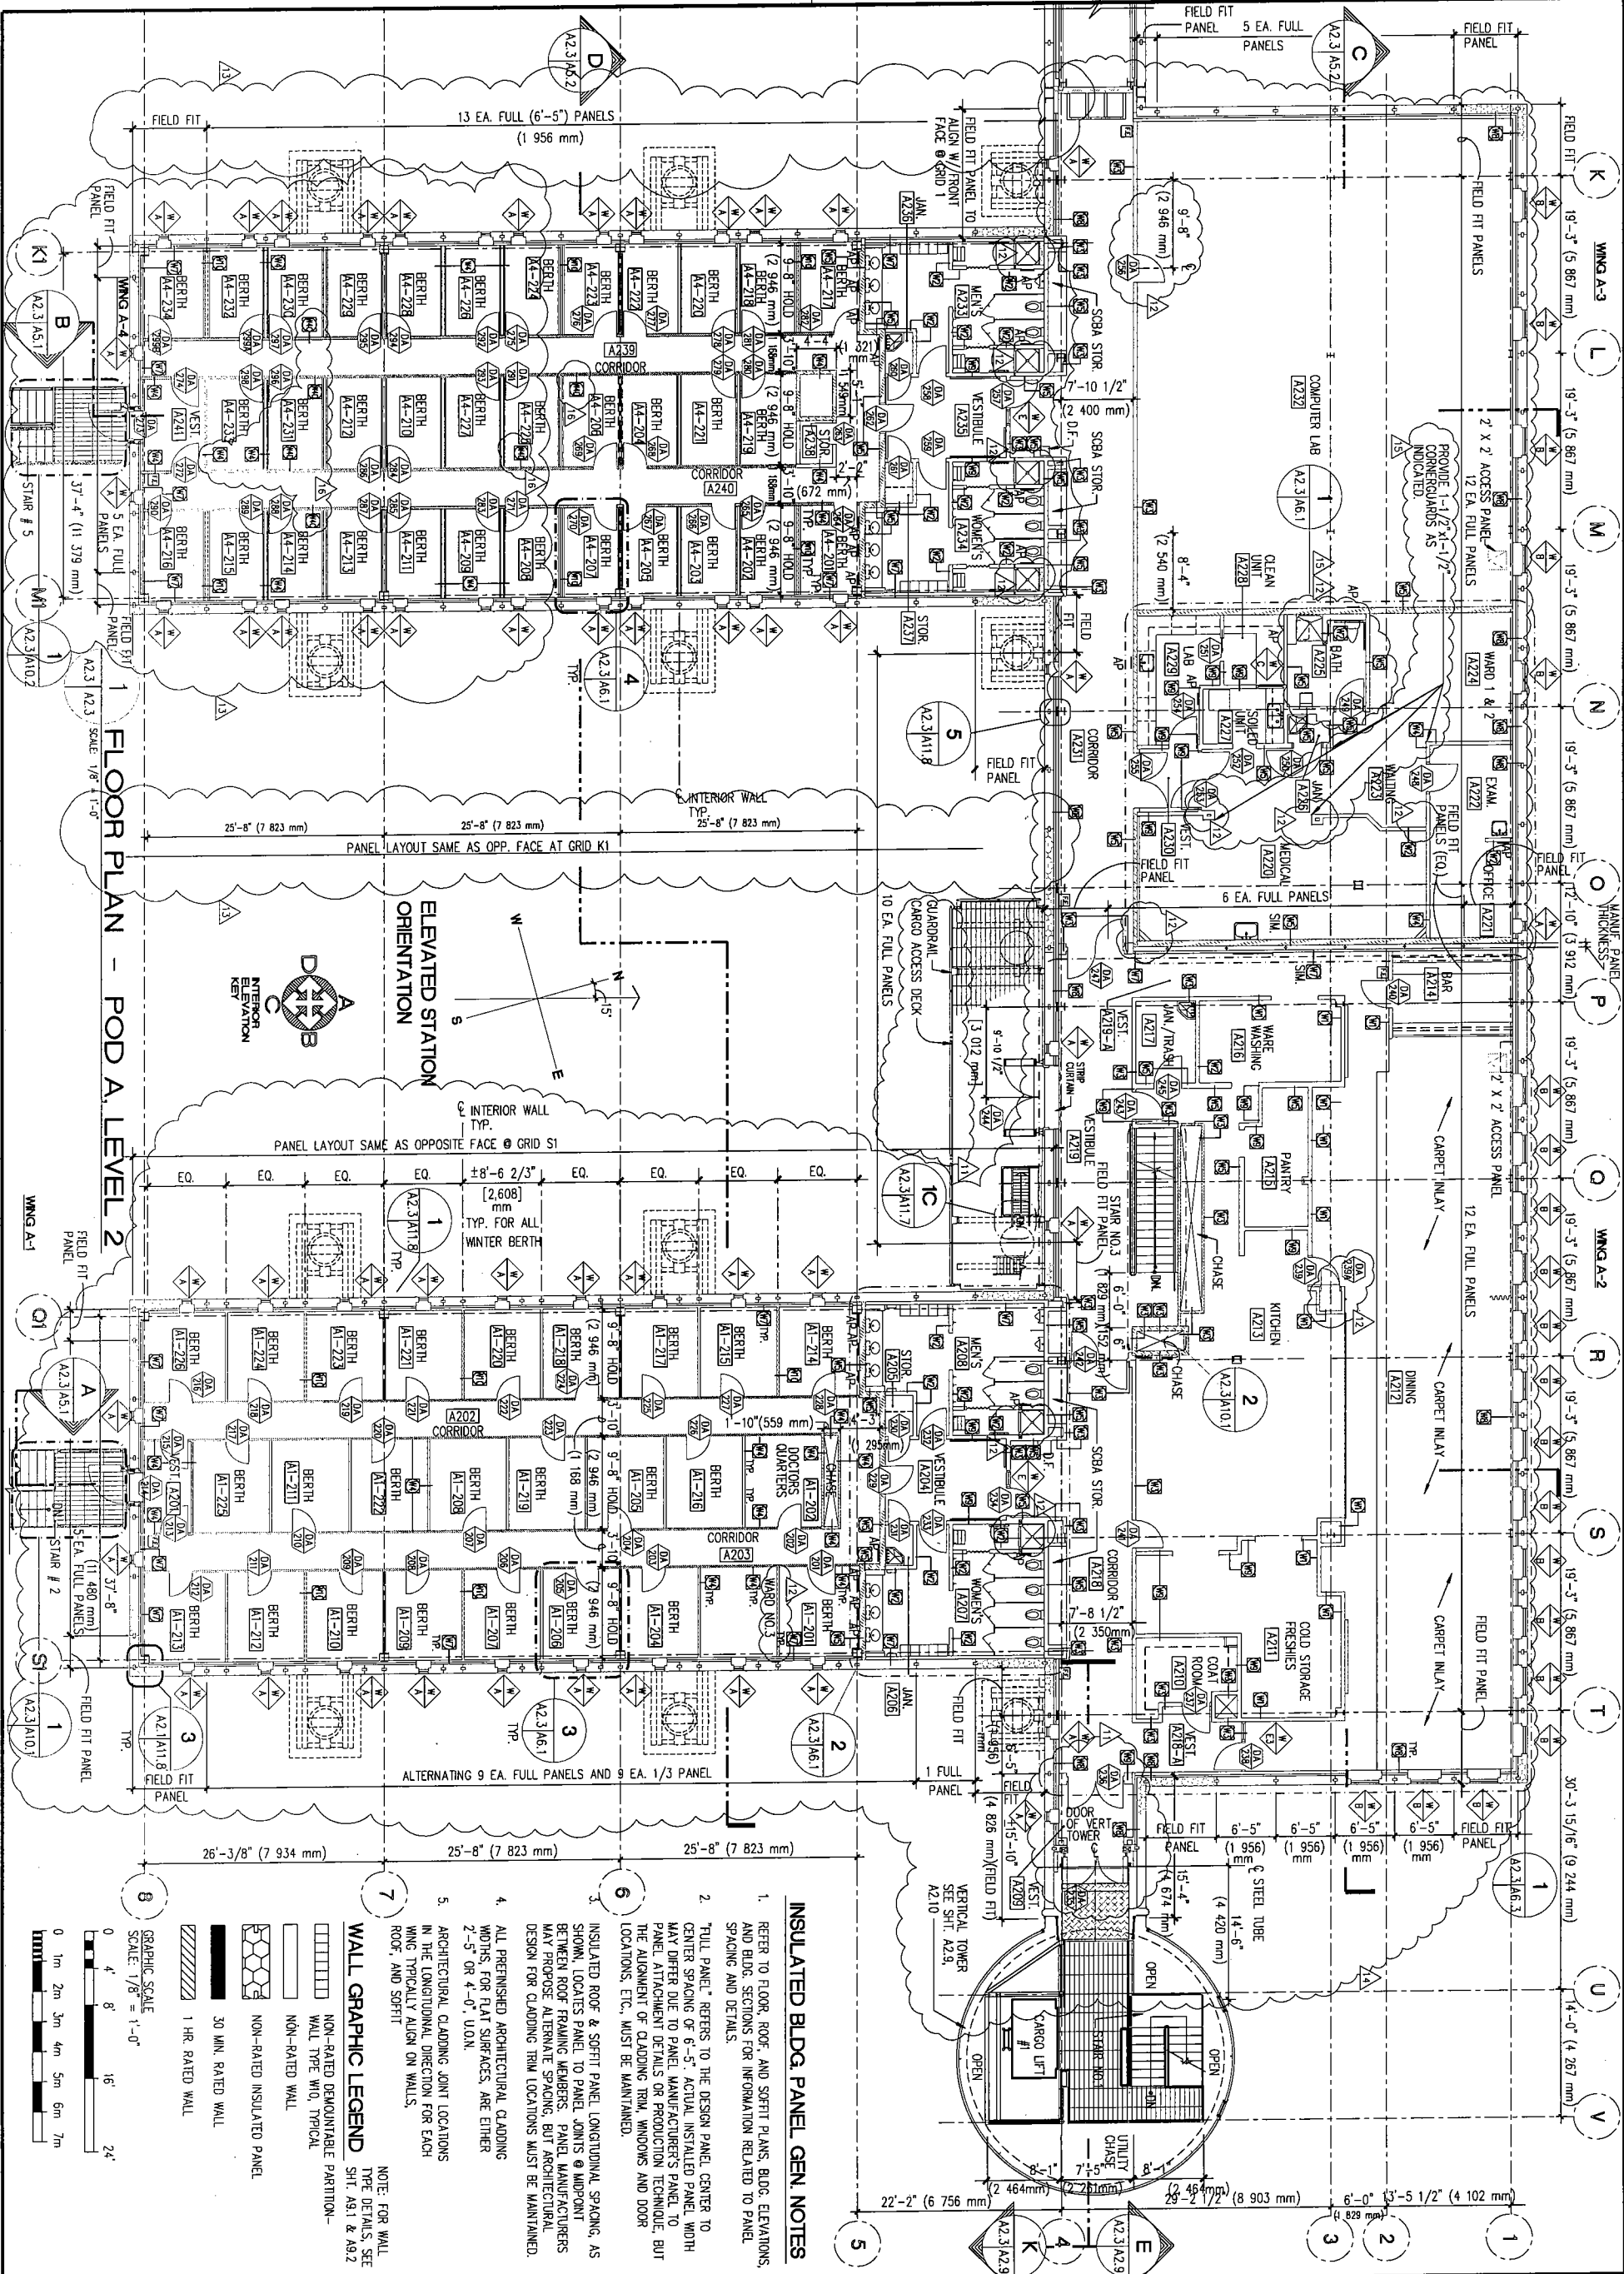

INSULATED BLDG. PANEL GEN. NOTES

1. REFER TO FLOOR, ROOF, AND SOFFIT PLANS, BLDG. ELEVATIONS, AND BLDG. SECTIONS FOR INFORMATION RELATED TO PANEL SPACING AND DETAILS.
2. "FULL PANEL" REFERS TO THE DESIGN PANEL, CENTER TO CENTER SPACING OF 6'-5". ACTUAL INSTALLED PANEL WIDTH MAY DIFFER DUE TO PANEL MANUFACTURER'S PANEL TO PANEL ATTACHMENT DETAILS OR PRODUCTION TECHNIQUE, BUT THE ALIGNMENT OF CLADDING TRIM, WINDOWS AND DOOR LOCATIONS, ETC., MUST BE MAINTAINED.
3. INSULATED ROOF & SOFFIT PANEL, LONGITUDINAL SPACING, AS SHOWN, LOCATES PANEL TO PANEL JOINTS @ MIDPOINT BETWEEN ROOF FRAMING MEMBERS. PANEL MANUFACTURERS MAY PROPOSE ALTERNATE SPACING, BUT ARCHITECTURAL DESIGN FOR CLADDING TRIM LOCATIONS MUST BE MAINTAINED.
4. ALL PREFINISHED ARCHITECTURAL CLADDING WIDTHS, FOR FLAT SURFACES, ARE EITHER 2'-5" OR 4'-0", U.O.N.
5. ARCHITECTURAL CLADDING JOINT LOCATIONS IN THE LONGITUDINAL DIRECTION FOR EACH WING TYPICALLY ALIGN ON WALLS, ROOF, AND SOFFIT

WALL GRAPHIC LEGEND

- NON-RATED DEMOUNTABLE PARTITION-WALL TYPE W/IO, TYPICAL
- NON-RATED WALL
- NON-RATED INSULATED PANEL
- 30 MIN. RATED WALL
- 1 HR. RATED WALL

NOTE: FOR WALL TYPE DETAILS, SEE SHT. A8.1 & A9.2

GRAPHIC SCALE
SCALE: 1/8" = 1'-0"

0 4' 8' 16' 24'

0 1m 2m 3m 4m 5m 6m 7m

DEPARTMENT OF THE NAVY NAVAL FACILITIES ENGINEERING COMMAND PACIFIC DIVISION MAKALAPA, HAWAII SOUTH POLE STATION MODERNIZATION ELEVATED STATION FLOOR PLAN - POD A, LEVEL 2		FERRARO CHOI DES BB DR BW, EC CHK GC SUPV JF CH ENG SUBMITTED BY: DATE 06/08/98 PARTNER		PACDIV NPEC: RVD BR MGR DFPE PDE INBM DIR APPROVED DATE FOR COMMANDER, NAVFAC		11 XREF UPDATE / AS-BUILTS 12 13 CR 124, 13 CR 143, 13 RFI 143, 21 RFI 018, 13 CR 122, 13 RFI 123 & 20 CR 029 13 WING A-4 EXPANSION 14 AS-BUILTS 15 REV PER 21 RFI 017, 13 RFI 118 & 21 RFI 039 16 REV PER 15A RFI 010 LTR DESCRIPTION PREP'D BY DATE APPROVED		JB 11/21/03 JB 11/21/03 SR 04/23/04 JB 05/20/04 JB 08/24/04 JR 07/01/05	
---	--	--	--	---	--	--	--	--	--