


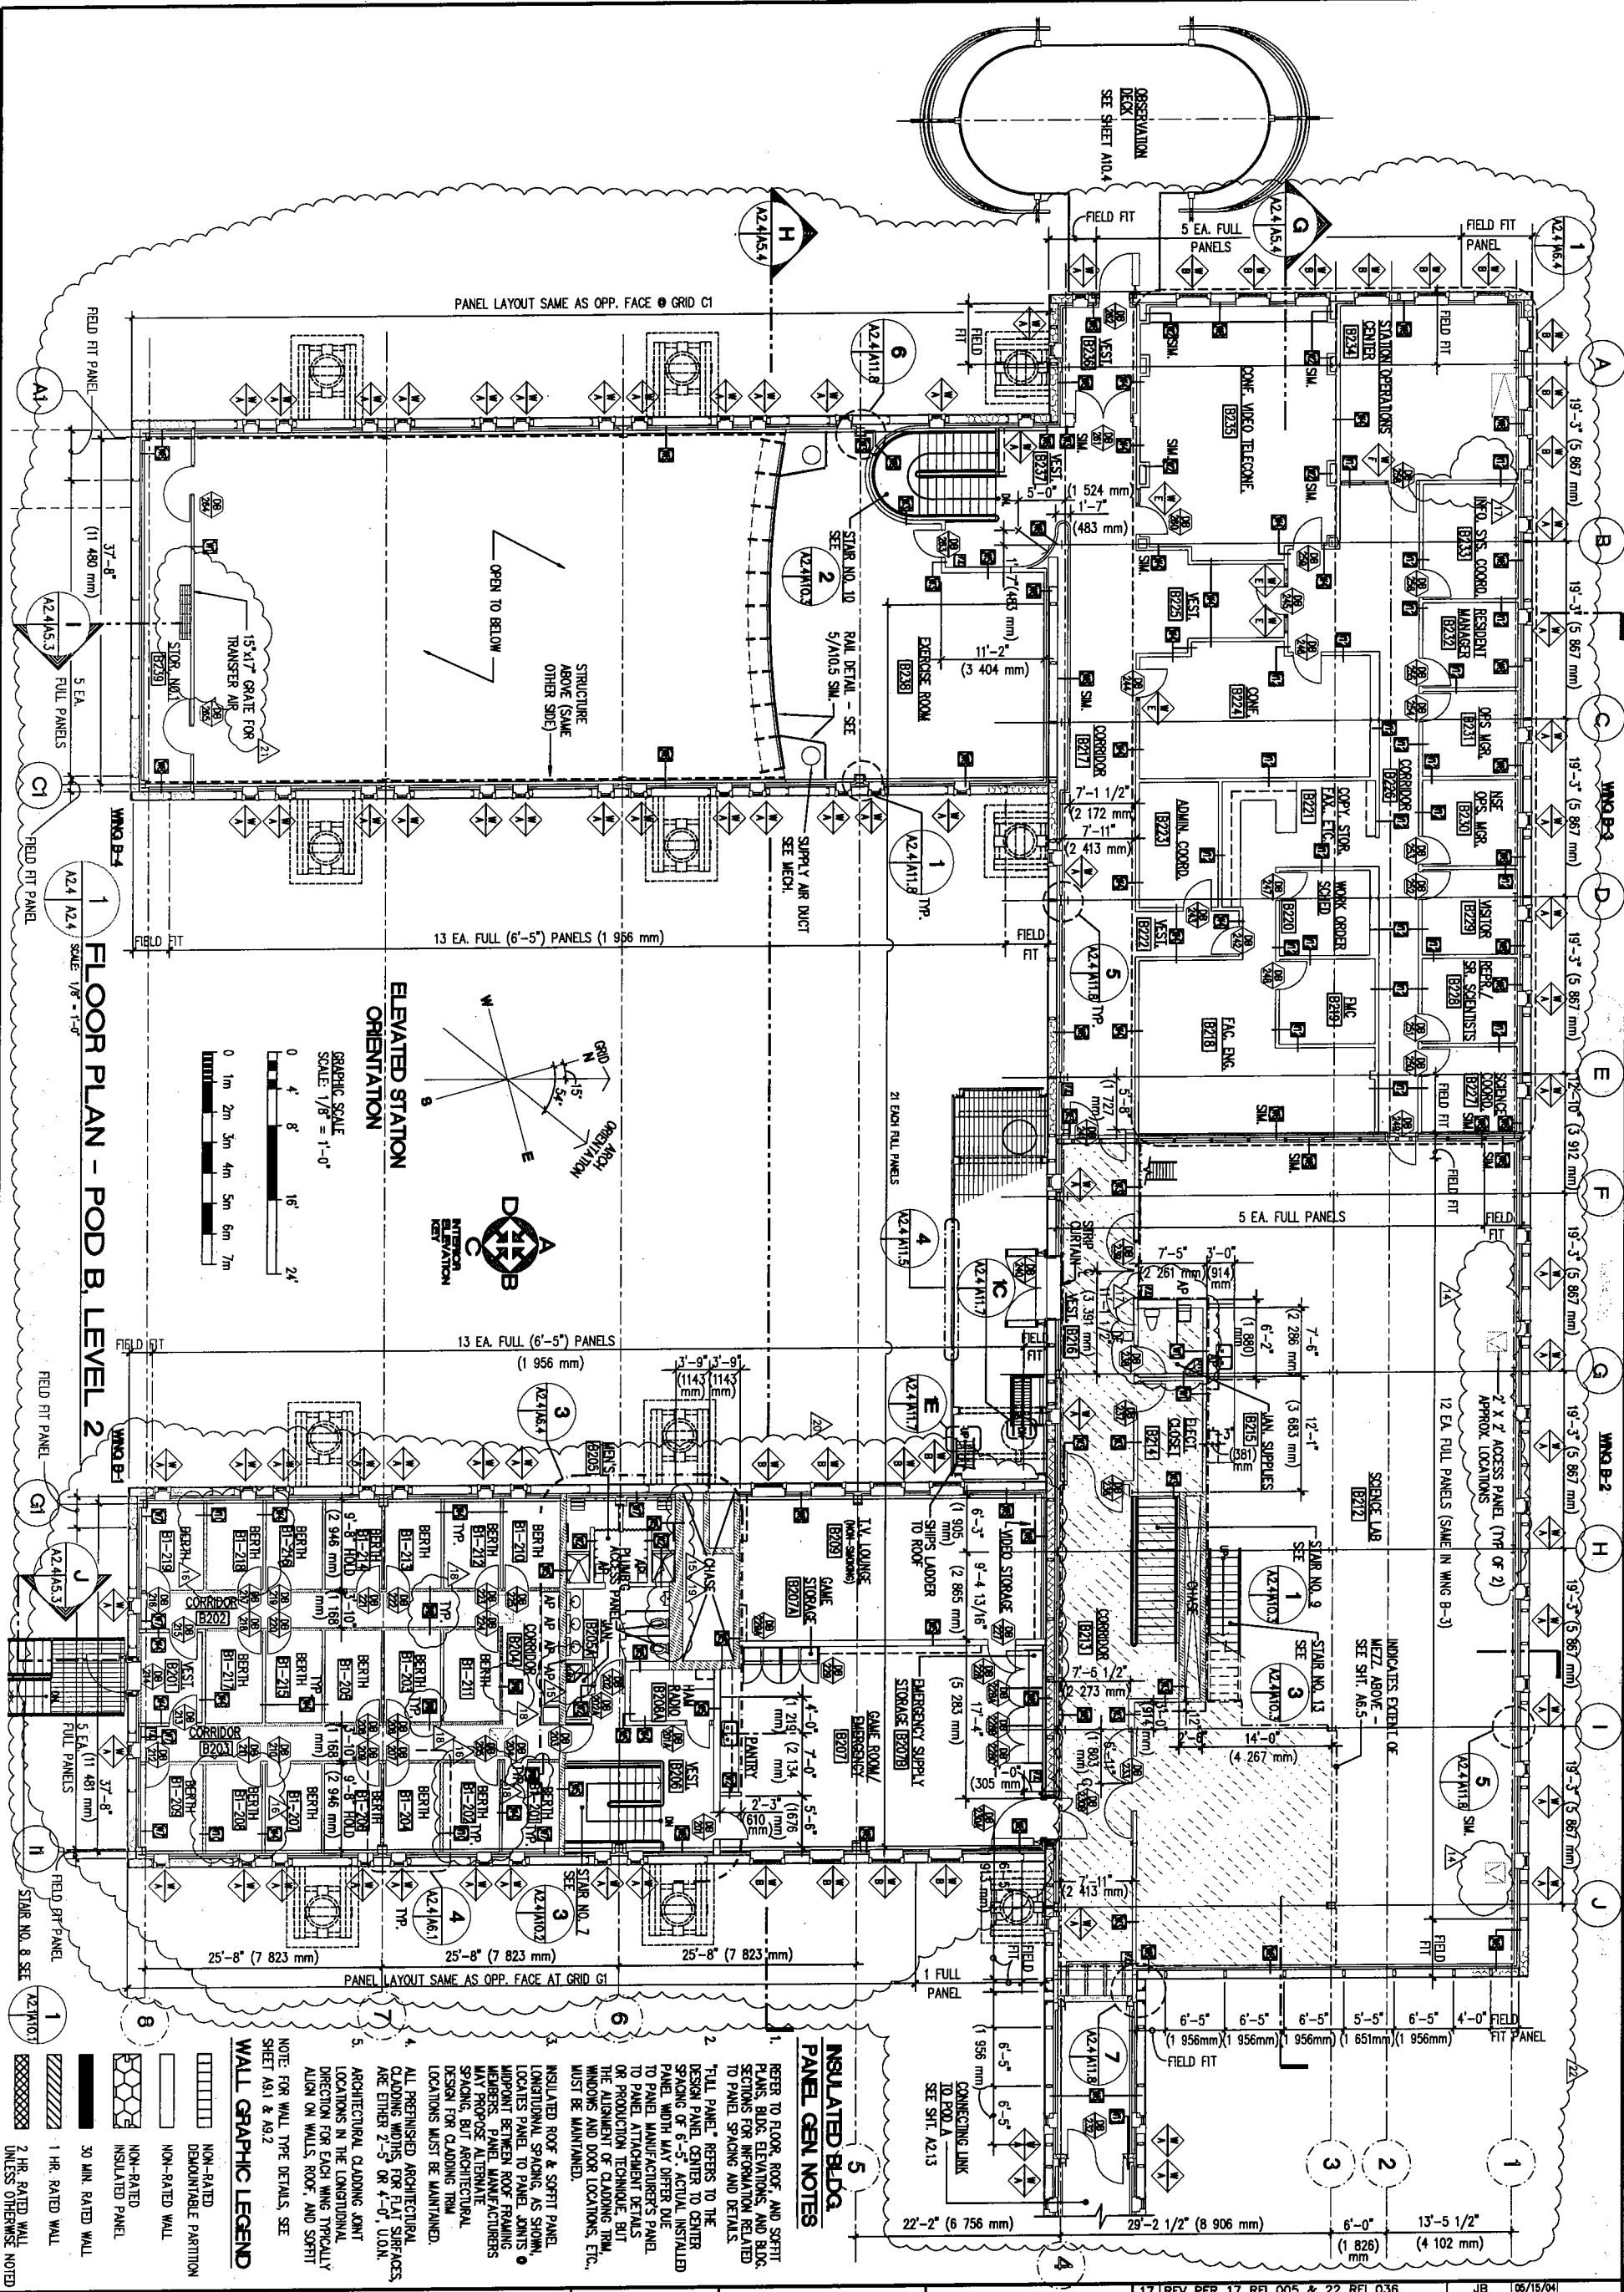

**INSULATED BLDG
PANEL GEN NOTES**

1. REFER TO FLOOR, ROOF, AND SOFFIT PLANS, BLDG. ELEVATIONS, AND BLOCK SECTIONS FOR INFORMATION RELATED TO PANEL SPACING AND DETAILS.

2. "FULL PANEL" REFERS TO THE DESIGN PANEL, CENTER TO CENTER SPACING OF 6'-5". ACTUAL INSTALLED PANEL WIDTH MAY DIFFER DUE TO PANEL MANUFACTURER'S PANEL OR PRODUCTION DETAILS.

3. THE ALIGNMENT OF CLADDING TRIM, WINDOWS AND DOOR LOCATIONS, ETC., MUST BE MAINTAINED.

4. INSULATED ROOF & SOFFIT PANEL, LONGITUDINAL SPACING, AS SHOWN, LOCATES PANEL TO PANEL JOINTS @ MIDPOINT BETWEEN ROOF FRAMING MEMBERS. PANEL MANUFACTURERS MAY PROPOSE ALTERNATE SPACING, BUT ARCHITECTURAL DESIGN FOR CLADDING TRIM LOCATIONS MUST BE MAINTAINED.

5. ALL PREFINISHED ARCHITECTURAL CLADDING WORKS, FOR FLAT SURFACES, ARE EITHER 2'-5" OR 4'-0", U.O.M.

6. ARCHITECTURAL CLADDING JOINT LOCATIONS IN THE LONGITUDINAL DIRECTION FOR EACH WING TYPICALLY ALIGN ON WALLS, ROOF, AND SOFFIT.

NOTE: FOR WALL TYPE DETAILS, SEE SHEET A9.1 & A9.2

WALL GRAPHIC LEGEND

- NON-RATED DEMOUNTABLE PARTITION
- NON-RATED WALL
- NON-RATED INSULATED PANEL
- 30 MIN. RATED WALL
- 1 HR. RATED WALL
- 2 HR. RATED WALL (UNLESS OTHERWISE NOTED)

DEPARTMENT OF THE NAVY NAVAL FACILITIES ENGINEERING COMMAND PACIFIC DIVISION MAKALAPA, HAWAII SOUTH POLE STATION MODERNIZATION ELEVATED STATION FLOOR PLAN - POD B, LEVEL 2		FERRARO CHOI DES BB DR BW EC CHK GC SUPV JF CH ENG SUBMITTED BY: DATE 04/08/09 PARTNER		PACDN NFD: RVD BR MGR DPFE PDE NBM DR APPROVED DATE FOR COMMANDER, NAVFAC		<table><tr><td>17</td><td>REV PER 17 RFI 005 & 22 RFI 036</td><td>JB</td><td>05/15/04</td></tr><tr><td>18</td><td>REV PER 24 RFI 045</td><td>JB</td><td>06/17/04</td></tr><tr><td>19</td><td>REV PER 24 RFI 015</td><td>JB</td><td>06/24/04</td></tr><tr><td>20</td><td>AS-BUILTS</td><td>JB</td><td>10/15/04</td></tr><tr><td>21</td><td>INTERIM CHANGE PENDING RFI</td><td>JR</td><td>06/17/05</td></tr><tr><td>22</td><td>INSULATED PANEL AS-BUILTS</td><td>JR</td><td>08/24/05</td></tr></table>		17	REV PER 17 RFI 005 & 22 RFI 036	JB	05/15/04	18	REV PER 24 RFI 045	JB	06/17/04	19	REV PER 24 RFI 015	JB	06/24/04	20	AS-BUILTS	JB	10/15/04	21	INTERIM CHANGE PENDING RFI	JR	06/17/05	22	INSULATED PANEL AS-BUILTS	JR	08/24/05
17	REV PER 17 RFI 005 & 22 RFI 036	JB	05/15/04																												
18	REV PER 24 RFI 045	JB	06/17/04																												
19	REV PER 24 RFI 015	JB	06/24/04																												
20	AS-BUILTS	JB	10/15/04																												
21	INTERIM CHANGE PENDING RFI	JR	06/17/05																												
22	INSULATED PANEL AS-BUILTS	JR	08/24/05																												
CODE IDENT NO. 80091 SIZE D CONST. CONTR. NO.		SHEET 7935234 OF A2.4		REVISIONS		PREP'D BY DATE APPROVED																									